
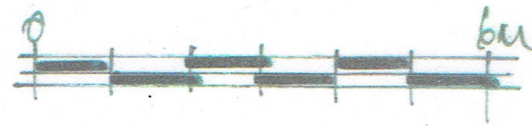
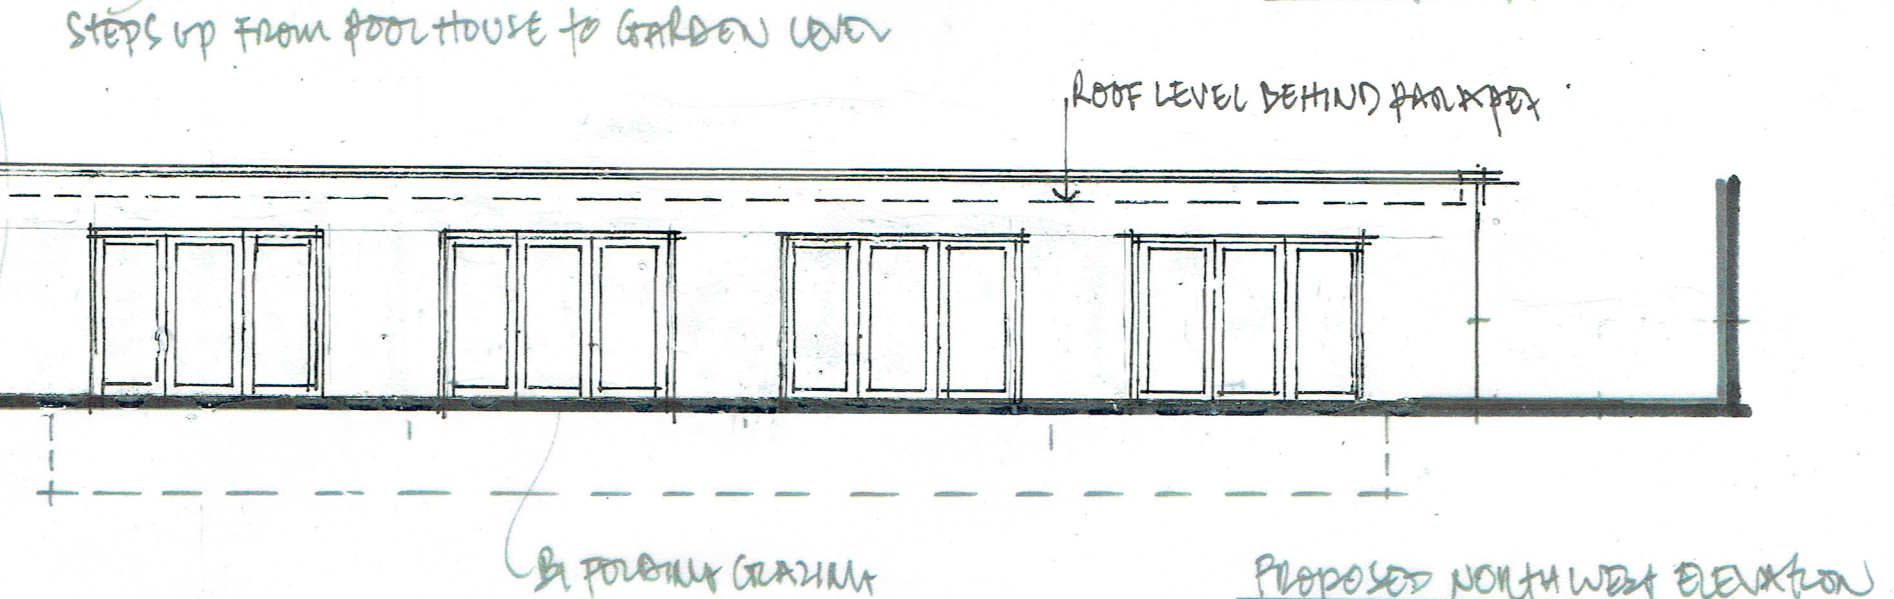
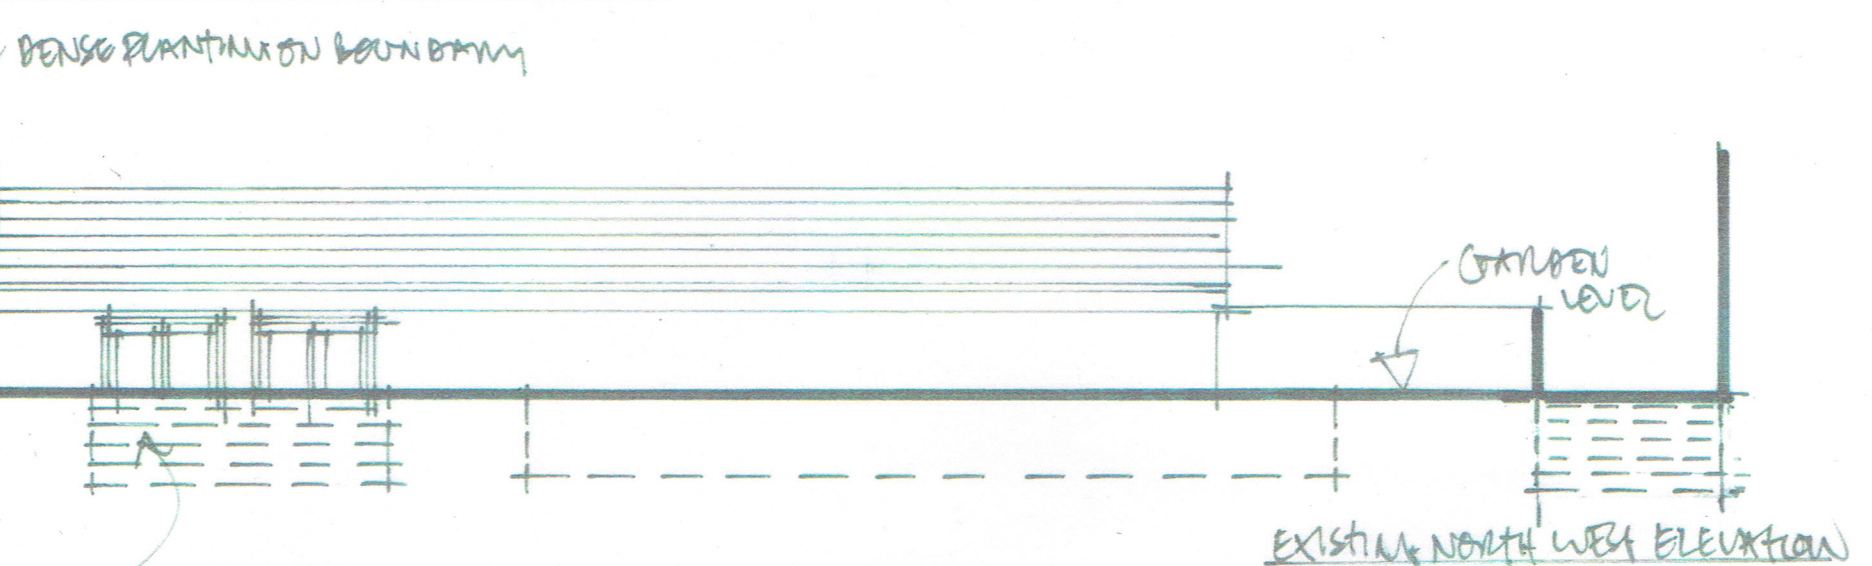
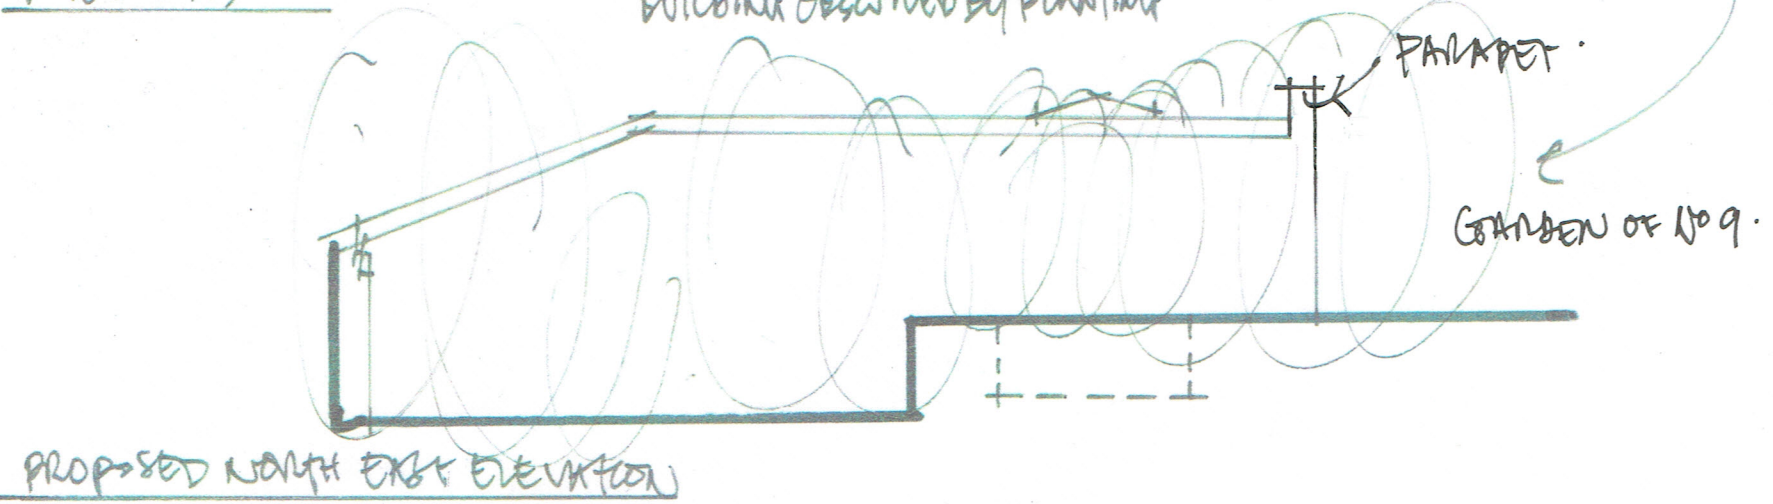


NOTE: ALL MATERIALS TO MATCH EXISTING

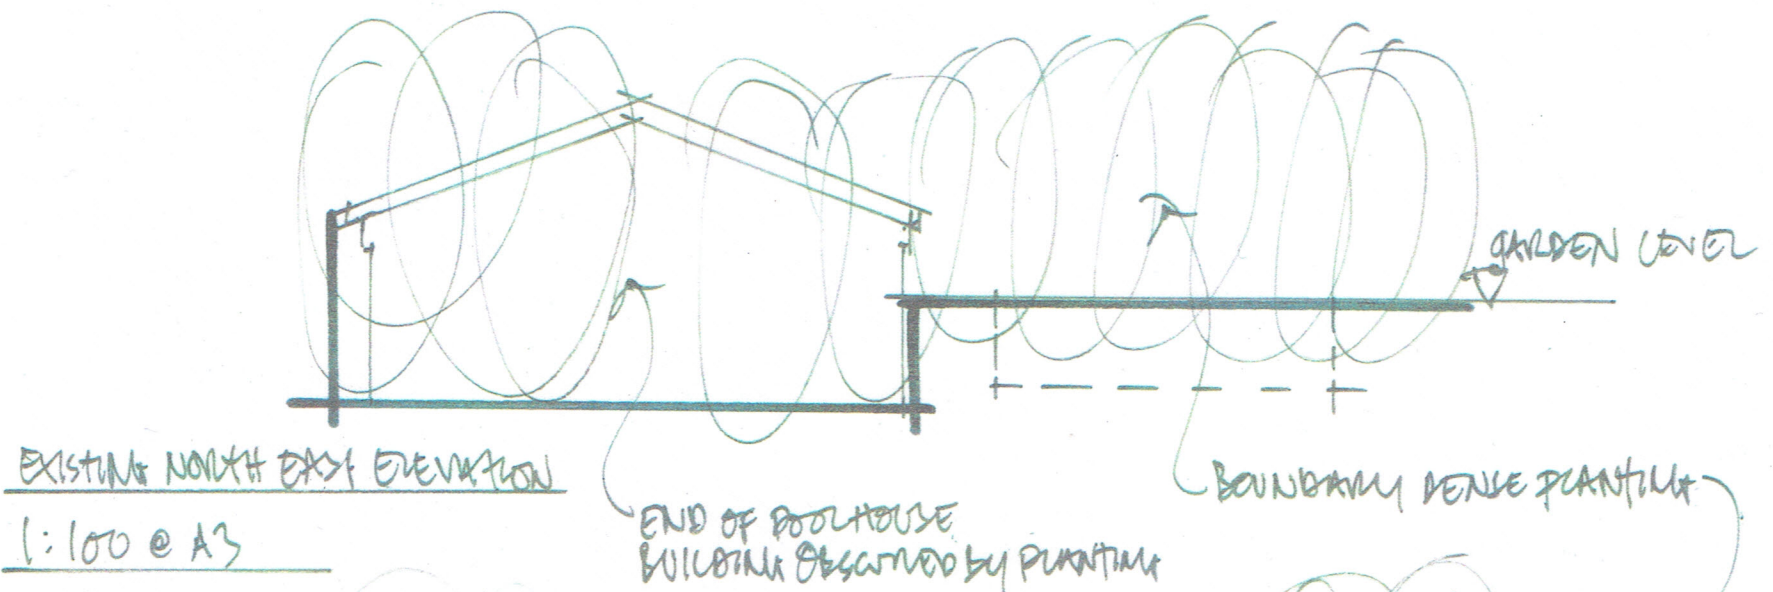

REV A - MAY 2019 - NORTH WEST ELEVATION REVISED TO SHOW AS BUILT SITUATION
NORTH EAST ELEVATION " " " " " "

9 KENDAL AVENUE EPPING
EXISTING & PROPOSED POOLHOUSE
DRG 16007_016A MAY 2016

PAUL SAGGERS ASSOCIATES
ARCHITECTS
PROJECT MANAGERS